

COMMONS REGISTRATION ACT 1965

Note: This section contains the registration of the land  
comprised in this register unit.

Registration authority

Powys

**Register of Common Land**

CWM EDNANT, RHIW GOCH, MOELFRE ETC.

Register unit No. MCL076

Edition No.

LAND SECTION - Sheet No. 1

No. and date of entry	Description of the land, reference to the register map, registration particulars etc.
1 04/11/1969	<p>THE TRACT OF LAND 775.914 HA (1917.732 ACRES) OR THEREABOUTS COMPRISING CWM EDNANT, RHIW GOCH, MOELFRE, WAEN TY-ISAF, CWM WERN-FACH, FFRIDD DOLGADFAN, BWLCH GLYNMYNYDD, BANC BRONDERWGOED, BANC MELYN, MOELFRE FACH AND LLANERCH-YR-AUR IN THE PARISHES OF DAROWEN AND LLANBRYNMAIR, AS MARKED WITH A GREEN VERGE LINE INSIDE THE BOUNDARY ON SHEETS 76A, B, C OF THE REGISTER MAP AND DISTINGUISHED BY THE NUMBER OF THIS REGISTER UNIT. REGISTERED PURSUANT TO APPLICATION NO. 398 MADE 27TH OCTOBER 1969, BY THE RAMBLER'S ASSOCIATION OF 124 FINCHLEY ROAD, LONDON, NW3.</p> <p><b>Common Acreage:</b> 1917.732</p> <p><b>Commons Commissioners Decision :</b> THE REGISTRATION AT ENTRY NO. 1 ABOVE, BECAME FINAL ON THE 26TH JULY 1973, WITH THE FOLLOWING MODIFICATION:- A) THE AREA TO READ 404.804 HA (1000.505 ACRES) OR THEREABOUTS. B) THE LAND HATCHED BLACK COMPRISING AN AREA OF 371.110 HA (917.227 ACRES) HAS BEEN REMOVED FROM THE REGISTER.</p> <p><b>Registration Amendment :-</b> 30/10/84 THE PART OF THE LAND, NAMELY FFRIDD CWM-BYCHAN-MAWR, COMPRISED IN THIS REGISTER UNIT, CEASED TO BE COMMON LAND ON 23RD OCTOBER 1984, AND IS REMOVED FROM THE REGISTER, PURSUANT TO APPLICATIONS MADE 23RD NOVEMBER 1983 AND 21ST AUGUST 1984 BY MESSRS E W PUGH AND MR/S J T JONES.</p>



24 May 2004

Reproduced from the Ordnance Survey mapping with the permission of the Controller of HMDO © Crown Copyright. Unauthorised reproduction infringes Crown Copying and may lead to prosecution or civil proceedings. Powys County Council LA100025371 2004. This copy has been produced specifically to supply an individual with Authority information. No further copies may be made. Additional information © Powys CC.

Extract from Commons Registration Map Register

Sheet No. SN 89 NE

Unit No. MCL 76

COMMONS REGISTRATION ACT, 1965  
 24 MAY 2004  
 POWYS COUNTY COUNCIL  
 LOCAL AUTHORITY




Land Removed from Registration



Common Land Boundary



Ownership or Grazier Boundary

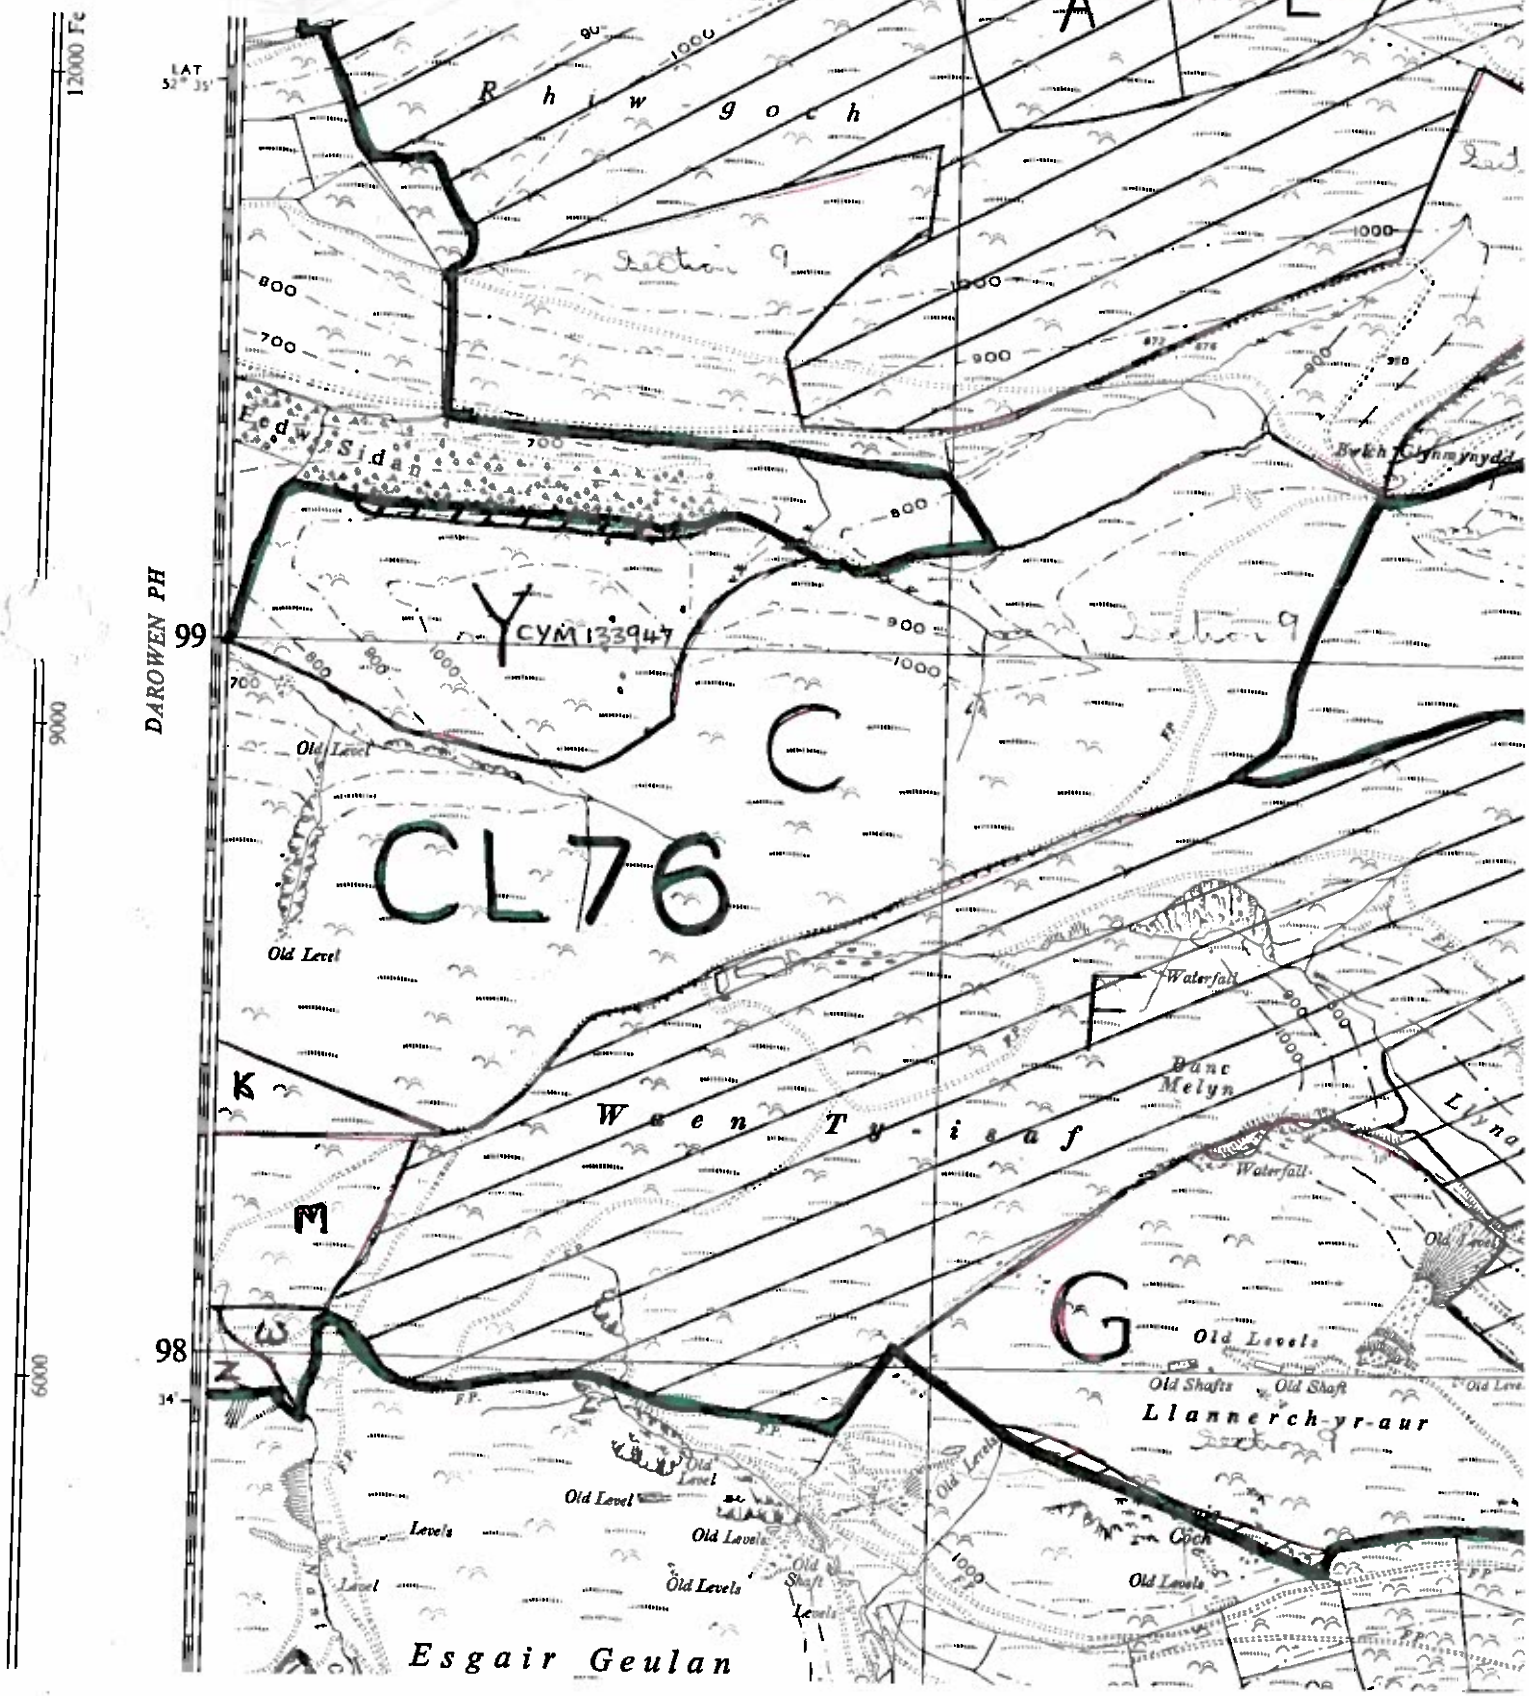

COMMONS REGISTRATION ACT 1966

Register of Common Land

CWM EDNANT, RHIV GOCH, MOELFRE ETC.

OWNERSHIP SECTION - Sheet No.

Note: This section contains the registration of every person registered under the Act as owner of any of the land described in the land section of this register unit. It does not contain any registration in respect of land of which the freehold is registered under the Land Registration Acts 1925 and 1936, but the absence from this section of a registration in respect of any land described in the land section does not necessarily indicate that the freehold of that land is registered under those Acts.

Registration authority

Powys

Register unit No. MCL076

Edition No.

1 No. and date of entry	2 No. and date of application	3 Name and Address of person registered as owner	4 Particulars of the land to which the registration applies
13 10/04/1987	0	LAND REGISTERED UNDER LAND REGISTRATION ACTS 1925 AND 1936  SEE NOTE OVERLEAF	THE PART OF THE LAND COMPRISED IN THIS REGISTER UNIT THE BOUNDARIES OF WHICH ARE SHOWN BY RED LINES ON THE REGISTER MAP AND MARKED THEREIN WITH THE LETTER 'Y'.  OWNERSHIP REGISTRATION DELETED UNDER SECTION 12 OF THE ACT. 03/12/2003

Commoners Commission's Decision:

OWNERSHIP DETERMINED BY THE COMMONS COMMISSIONER AND STATED TO BE:-  
EVAN HUGH JONES.



Note 1.

Notes

10/12/2003

Entry No 13.

Title No CYM 133947 - B52 Notice 03/12/2003.

